


DP 366875
2

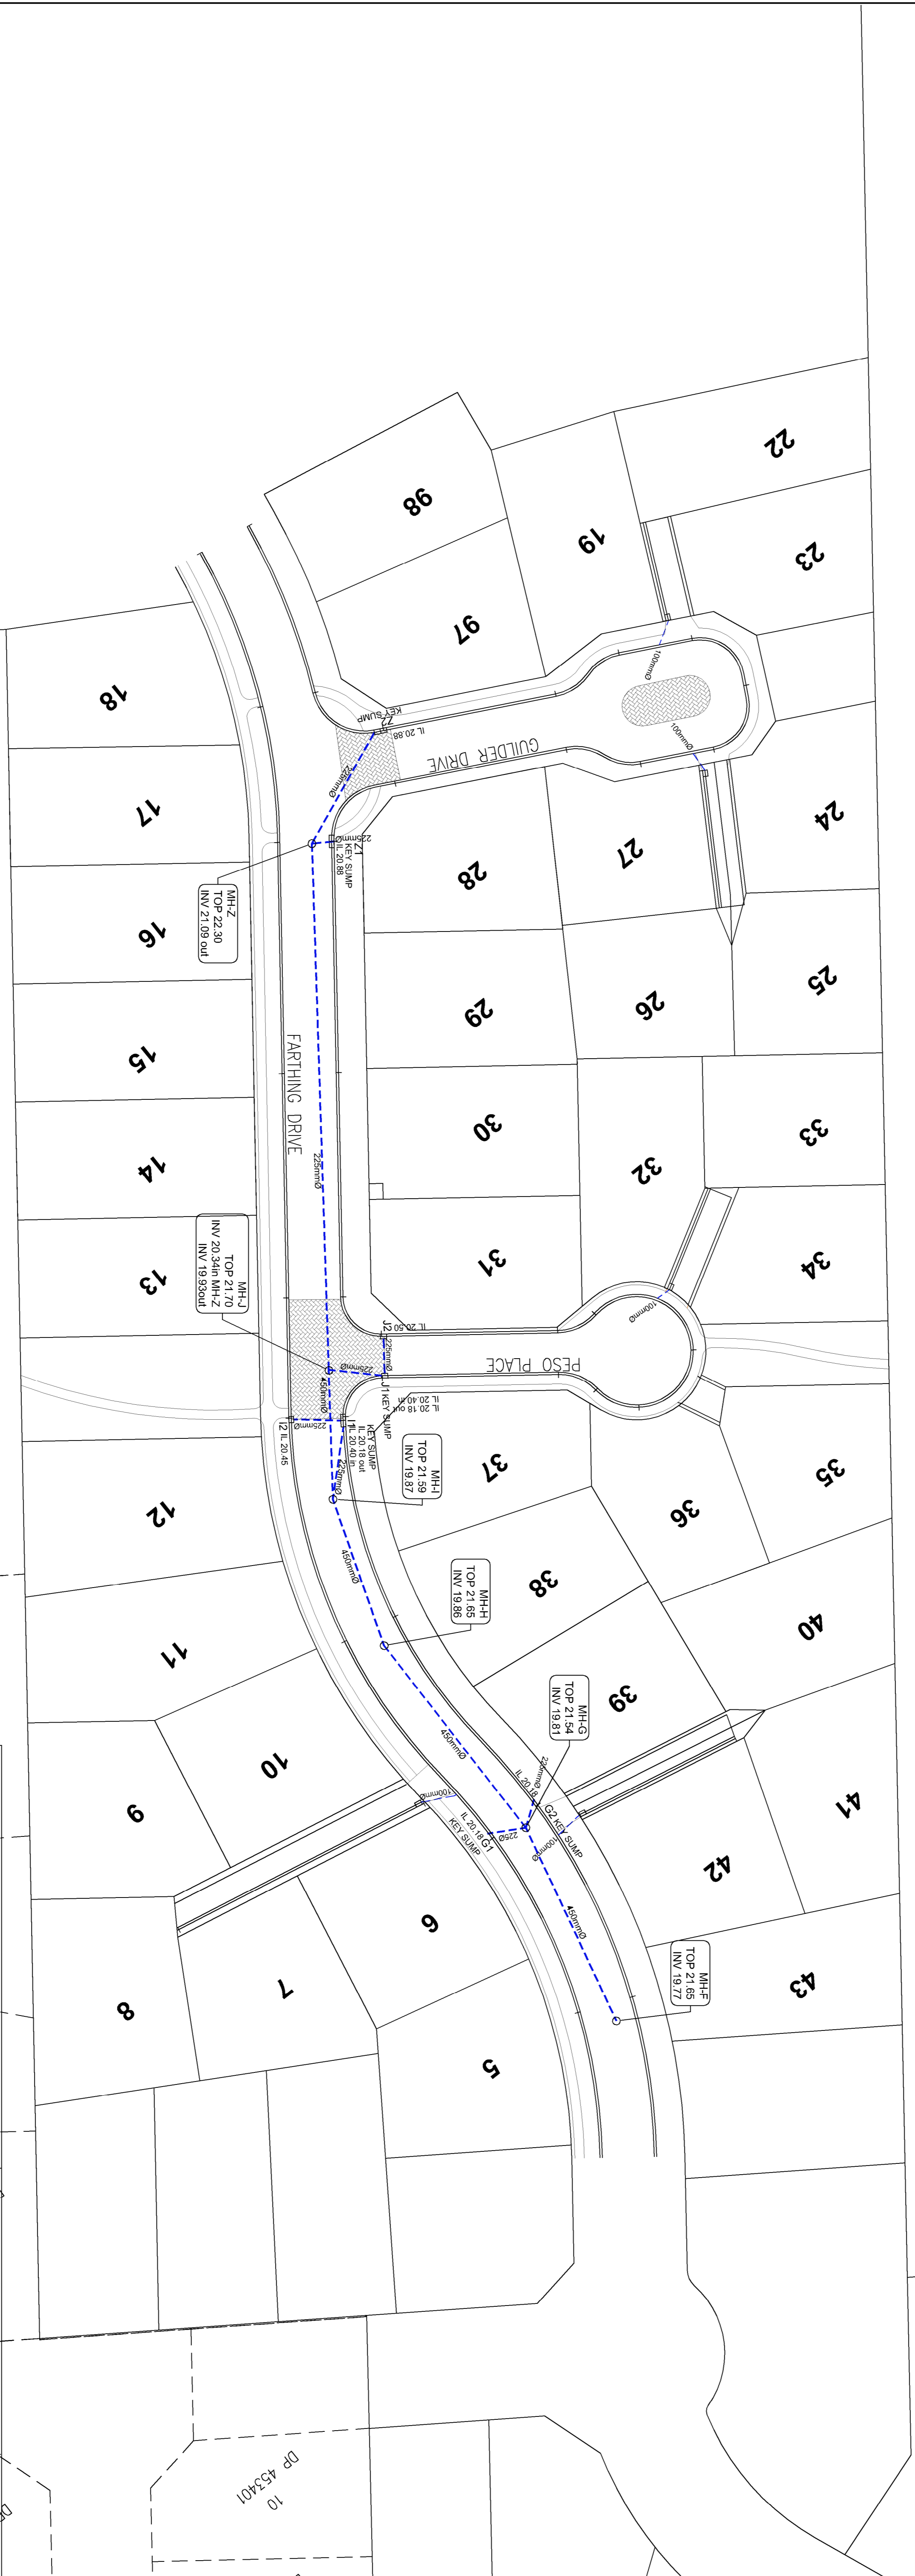

LEGEND

- SEWER MAN / MAN HOLE
- STORMWATER MAN / MAN HOLE
- KERB / SLUMP
- WATER MAN
- WATER METER
- HYDRANT
- VALVE

Job
STERLING PARK, PREBBLETON RC 155227 & 155227

Title
STORMWATER ASBUILT PLAN - STAGE 4 & 5

DP 453401
5

DP 453401
4

Issue	date	reason	approved
A	04/16	Issue	KS

Disclaimer: This document shall only be reproduced in full with approval from Suburban Estates contractor to locate all existing services & verify all dimensions before commencing work.

Origin of Levels **BM EKRR, CCC BM 148, RL 13,801**
 Level Datum **Mean sea level/Lytelton vertical datum 1937**
 Projection - New Zealand Geodetic 2000
 Circuit - Mount Pleasant

Design	KS/CP	Date	04/16
Drawn	CP	QA check	KS

SUBURBAN ESTATES
Developing land for better living

Phone: 03 3663729 Fax: 03 3654323 Web: www.suburban-estates.co.nz
 Unit 2 / 1 Homersham Place Burnside PO Box 13 349 Christchurch 8141
 New Zealand

AutoCAD ref: Prebbleton.Civil
 Sheet 2 of 4

Scale @ A3 1:1000
 Scale @ A1 1:500

Drawing **E6.2** Revision **A**